




ment Gardens

PROPOSED	
	DOUBLE YELLOW LINE
EXISTING	
	SINGLE YELLOW LINE
	DOUBLE YELLOW LINE
	CROSSOVER
	RESIDENTS BAYS
	SHARED USE BAY (R, B, P&P)
	DISABLED BAYS
	ZONE BOUNDARY
	DOUBLE RED LINE
	RED ROUTE BAY
	SIGN ON LC
	POST & SIGN

ADD EXISTING DOUBLE YELLOW LINE TO TRAFFIC ORDER TO CONSOLIDATE (TMO FOR JUNCTION SAFETY)

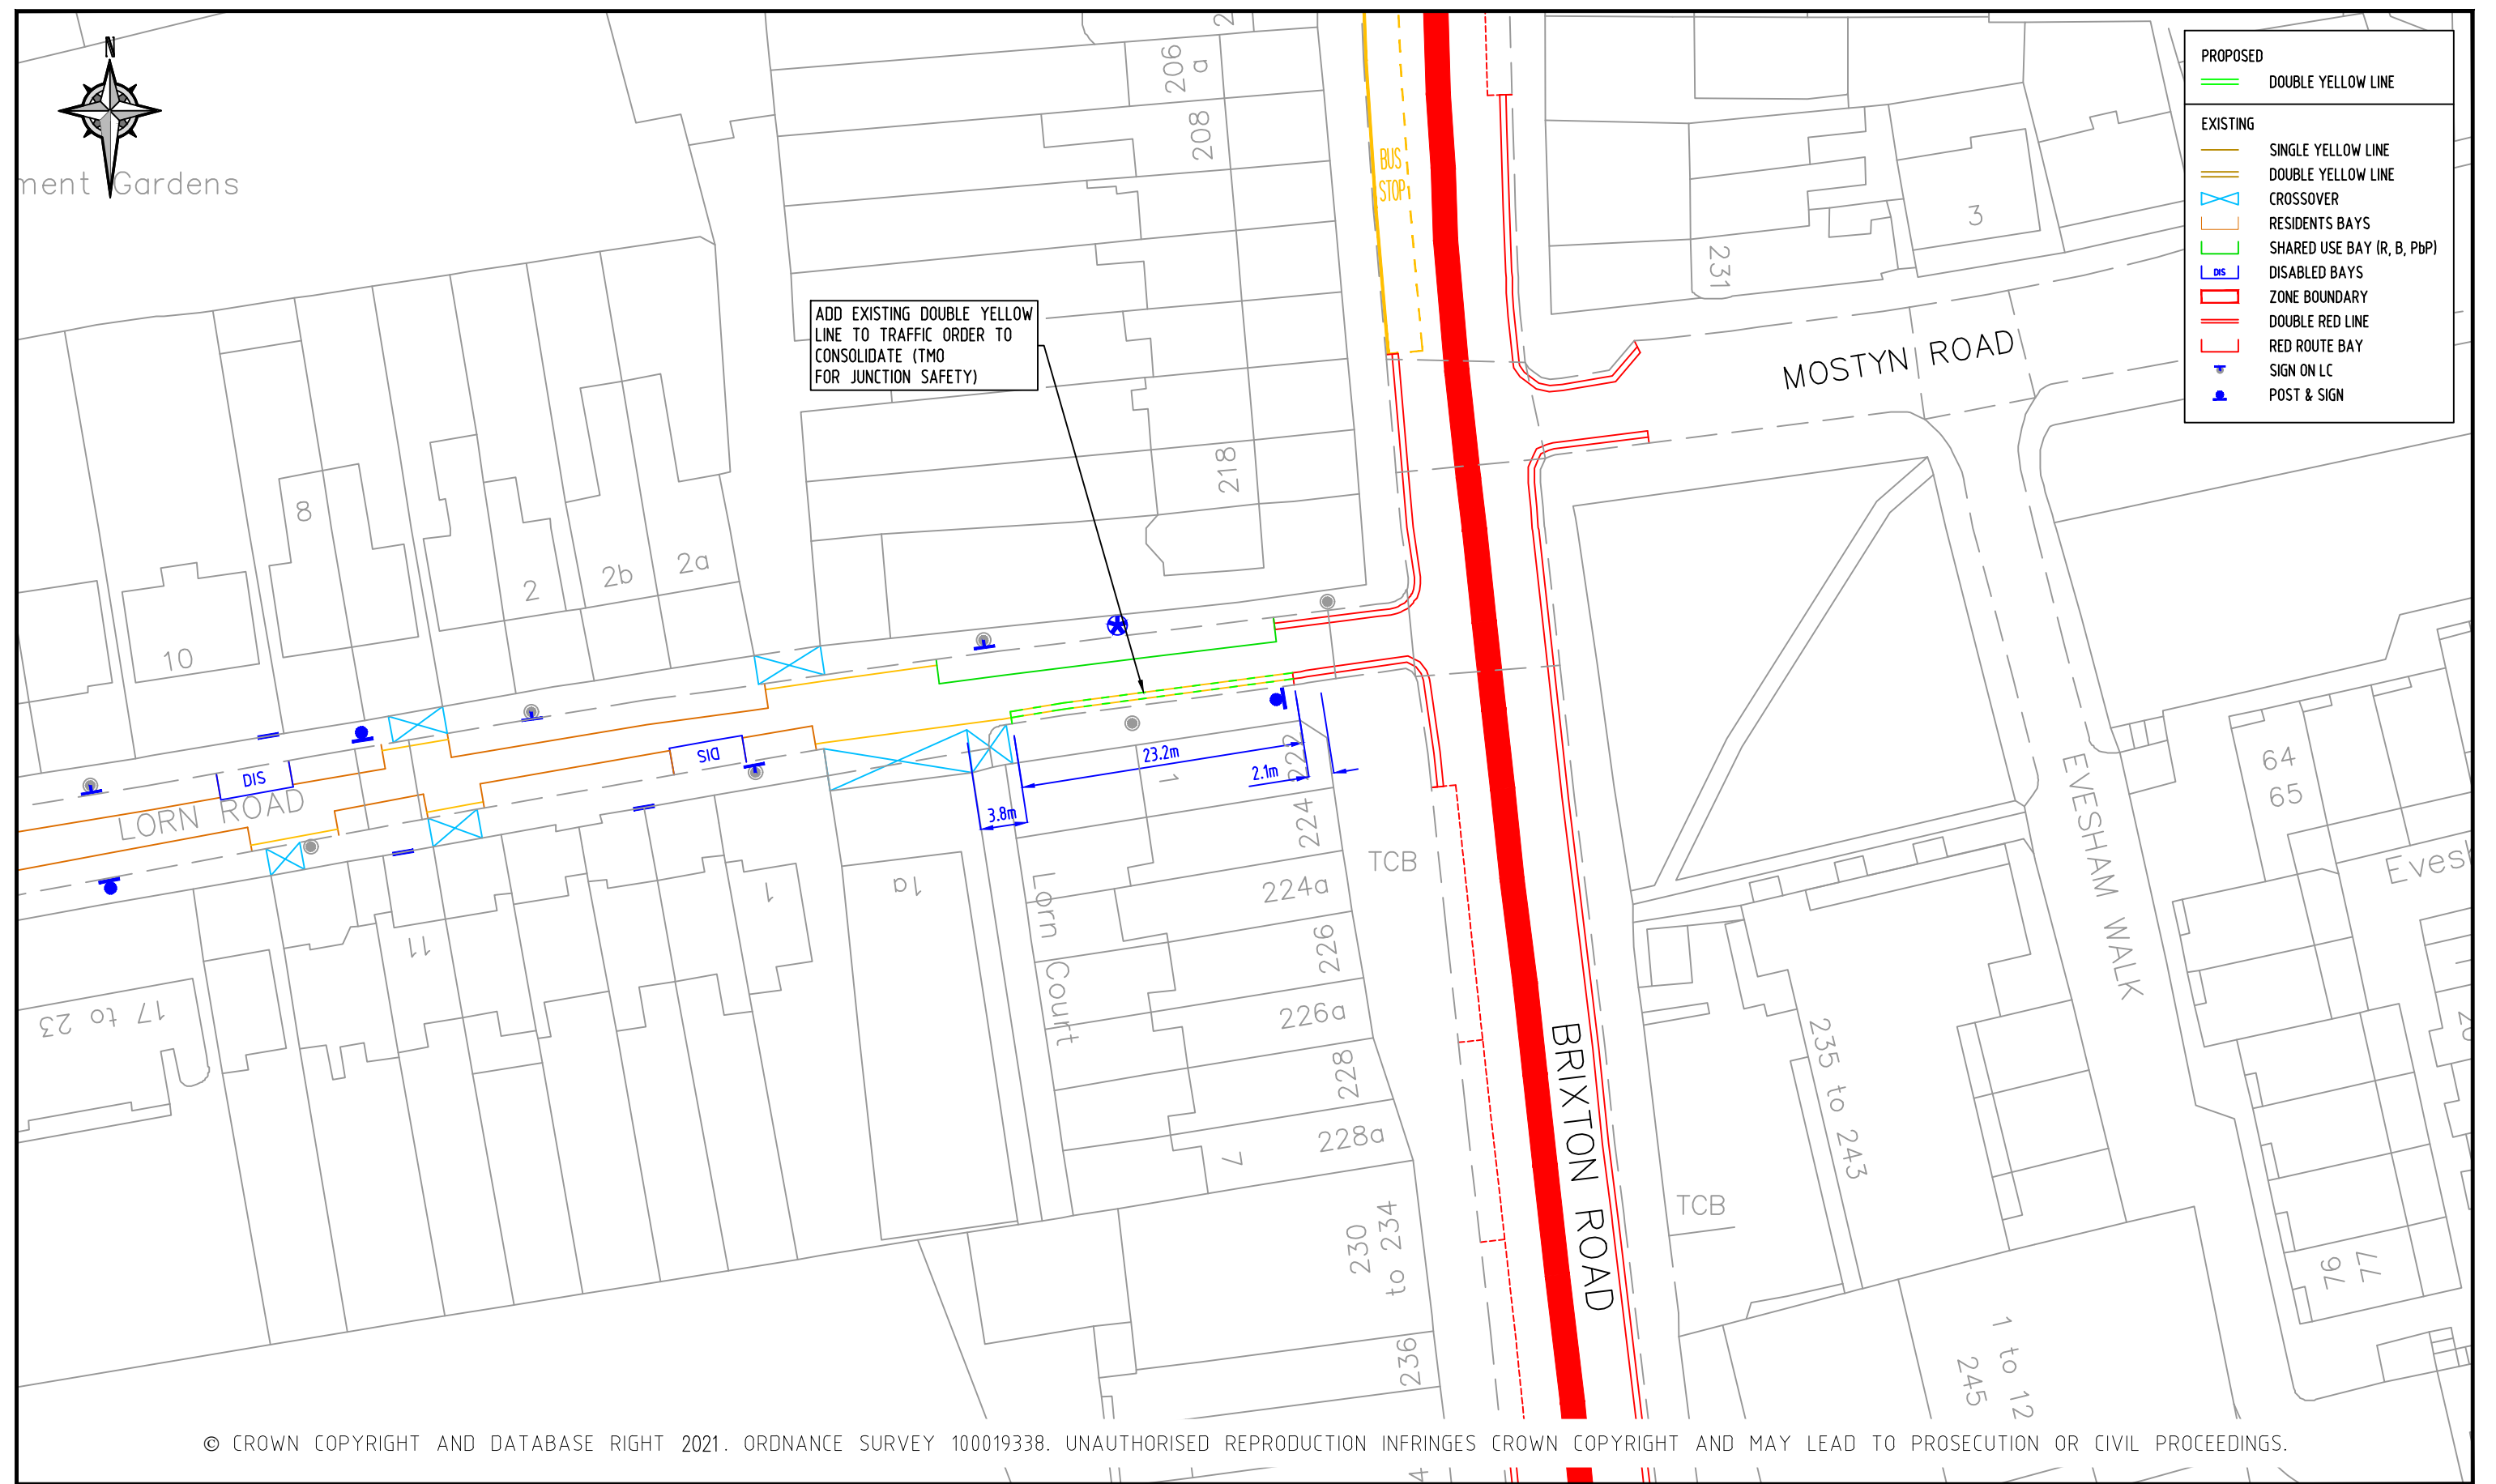

© CROWN COPYRIGHT AND DATABASE RIGHT 2021. ORDNANCE SURVEY 100019338. UNAUTHORISED REPRODUCTION INFRINGES CROWN COPYRIGHT AND MAY LEAD TO PROSECUTION OR CIVIL PROCEEDINGS.

NOTES:

REV	DESCRIPTION	DRAWN	SIG	DATE	CHKD	SIG	DATE	APP	SIG	DATE

**Lambeth**  
 PARKING, STREET MANAGEMENT AND COMMERCIAL,  
 3RD FLOOR, CIVIC CENTRE  
 6 BRIXTON HILL  
 LONDON, SW2 1EG  
 020 7926 9000

DRAWN	AF	PROJECT	PROPOSED CPZ AMENDMENTS		
CHKD	LM	DRAWING TITLE	LORN ROAD (CPZ 'S')		
APP	SC	CLASSIFICATION	TMO	PAPER	A3
		SCALE	1:500		
DATE	27.02.20	DRAWING NO	DES-CPZ-W&L-1001-003-11		REVISION
					-